


West Hoe Heights
Legal Road

(irregular width)

ref. trav sheet
page 1, line 21
Source DP211953

832996.88mN
392932.24mE

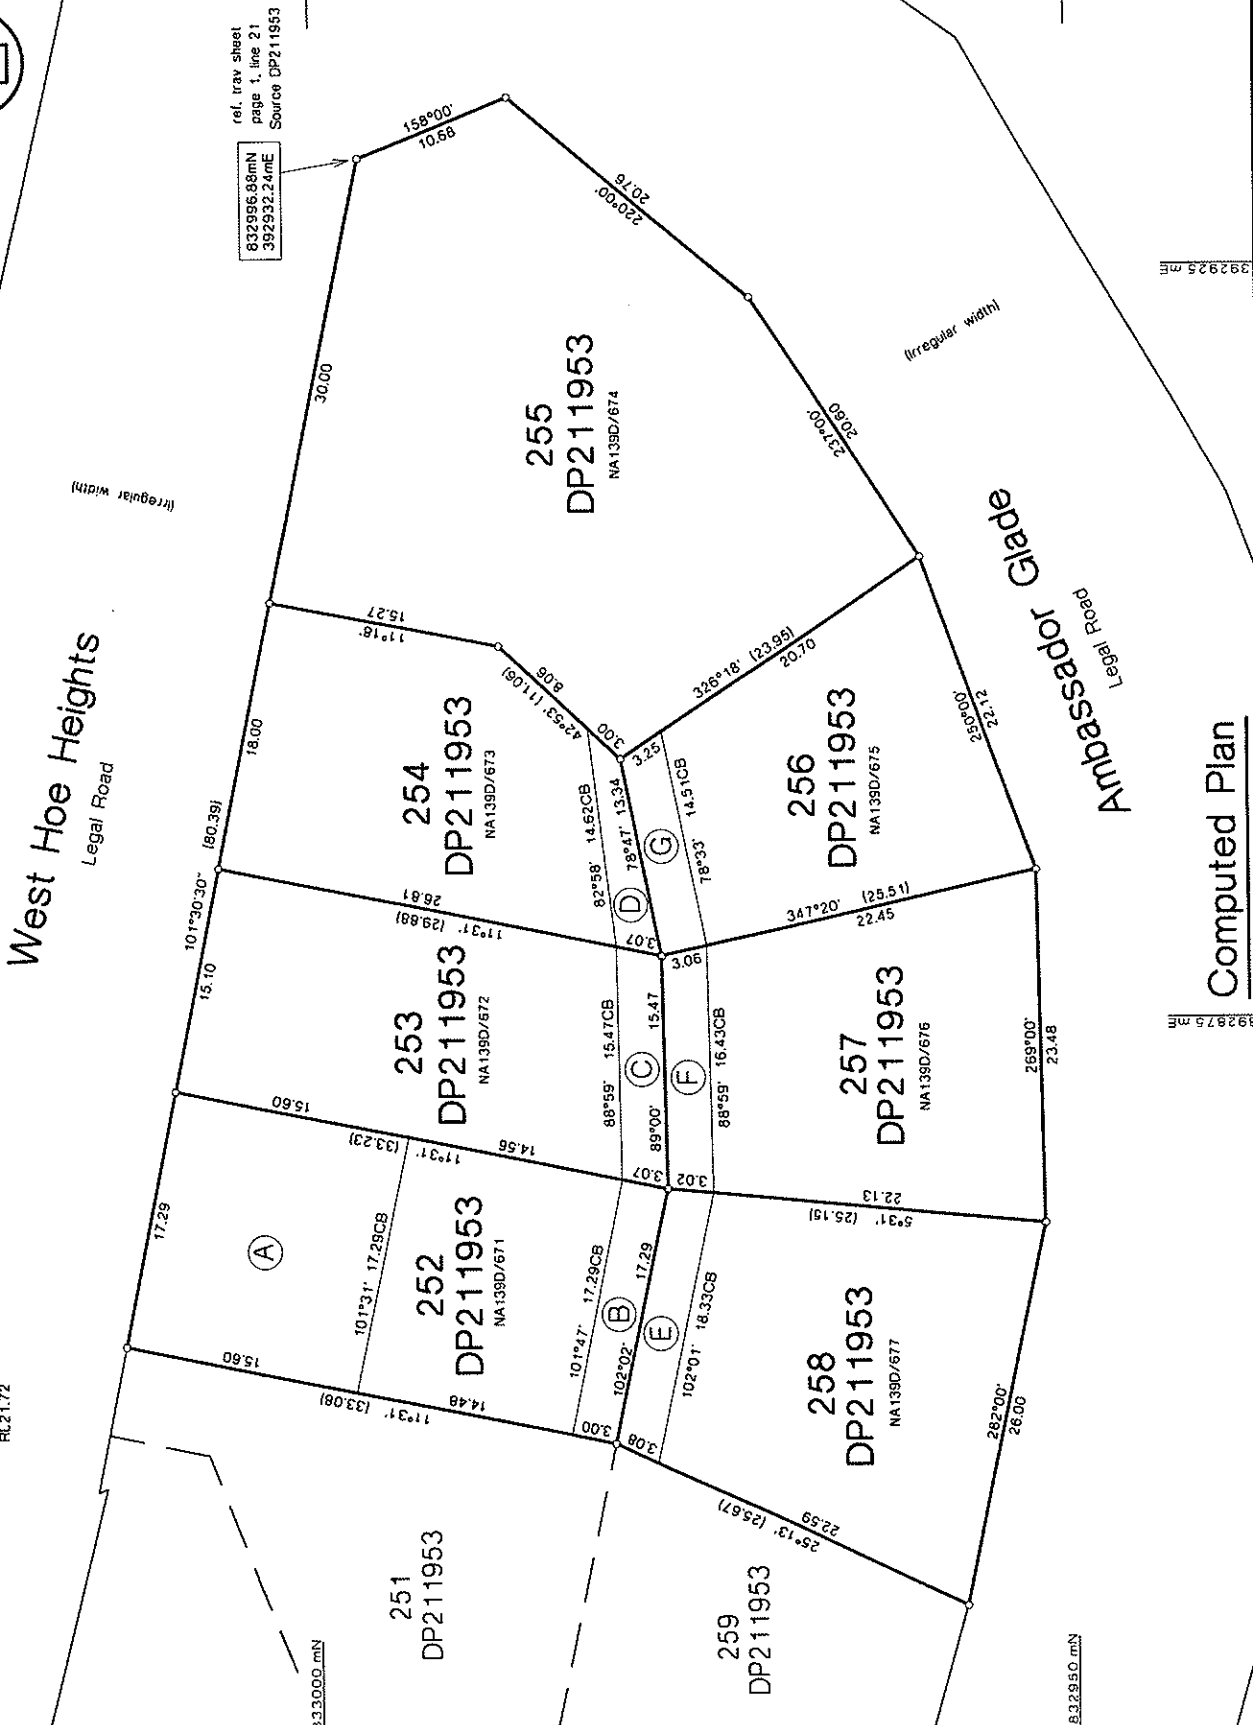

Areas A, B, C, D, E, F, G and Lot 255 to be subject to land coverants.

All boundaries adopted from DP211953

Proposed Height Restriction	
Shown	Maximum Height (RL)
Lot 255 DP211953 hereon	17.00m
(A)	23.00m

Note:
Levels are in terms of Lands & Survey Auckland Datum 1946
Origin of Levels: SM5314
SO55927
RL4.655

Bearing & Coordinate Datum: Geodetic 2000
Mt. Eden Circuit Coordinates
Origin: Mt. Eden 800 000 mN
400 000 mE

CLASS OF SURVEY: 1

Total Area

Comprised in C.T.'s 139D/671, 139D/672, 139D/673, 139D/674, 139D/675, 139D/676 and 139D/677.

I Richard Alan Bull being a person entitled to practice as a licensed cadastral surveyor, certify that—
of the surveys to which this document relates are accurate, and were undertaken by me or under my direction in accordance with the Cadastral Survey Act 2002 and the Surveyor-General's Rules for Cadastral Survey 2002/2.
If this document is accurate, and has been created in accordance with that Act and these Rules.

Signature

Date

Field Book

Reference Plans

Examined

Correct

Approved as to Survey by Land Information NZ on

Deposited by Land Information NZ on


20

File 2555
Received Instructions
DP390528
DWG2355T

TERRITORIAL AUTHORITY Rodney District
Surveyed by GFC & R SURVEYORS LTD
Scale 1:250 Date June 2007

Computed Plan
Covenants over Lots 252-258 DP211953

LAND DISTRICT North Auckland
Survey Blk. & Dist.
NZMS 261 Sheet Record Sheet No.

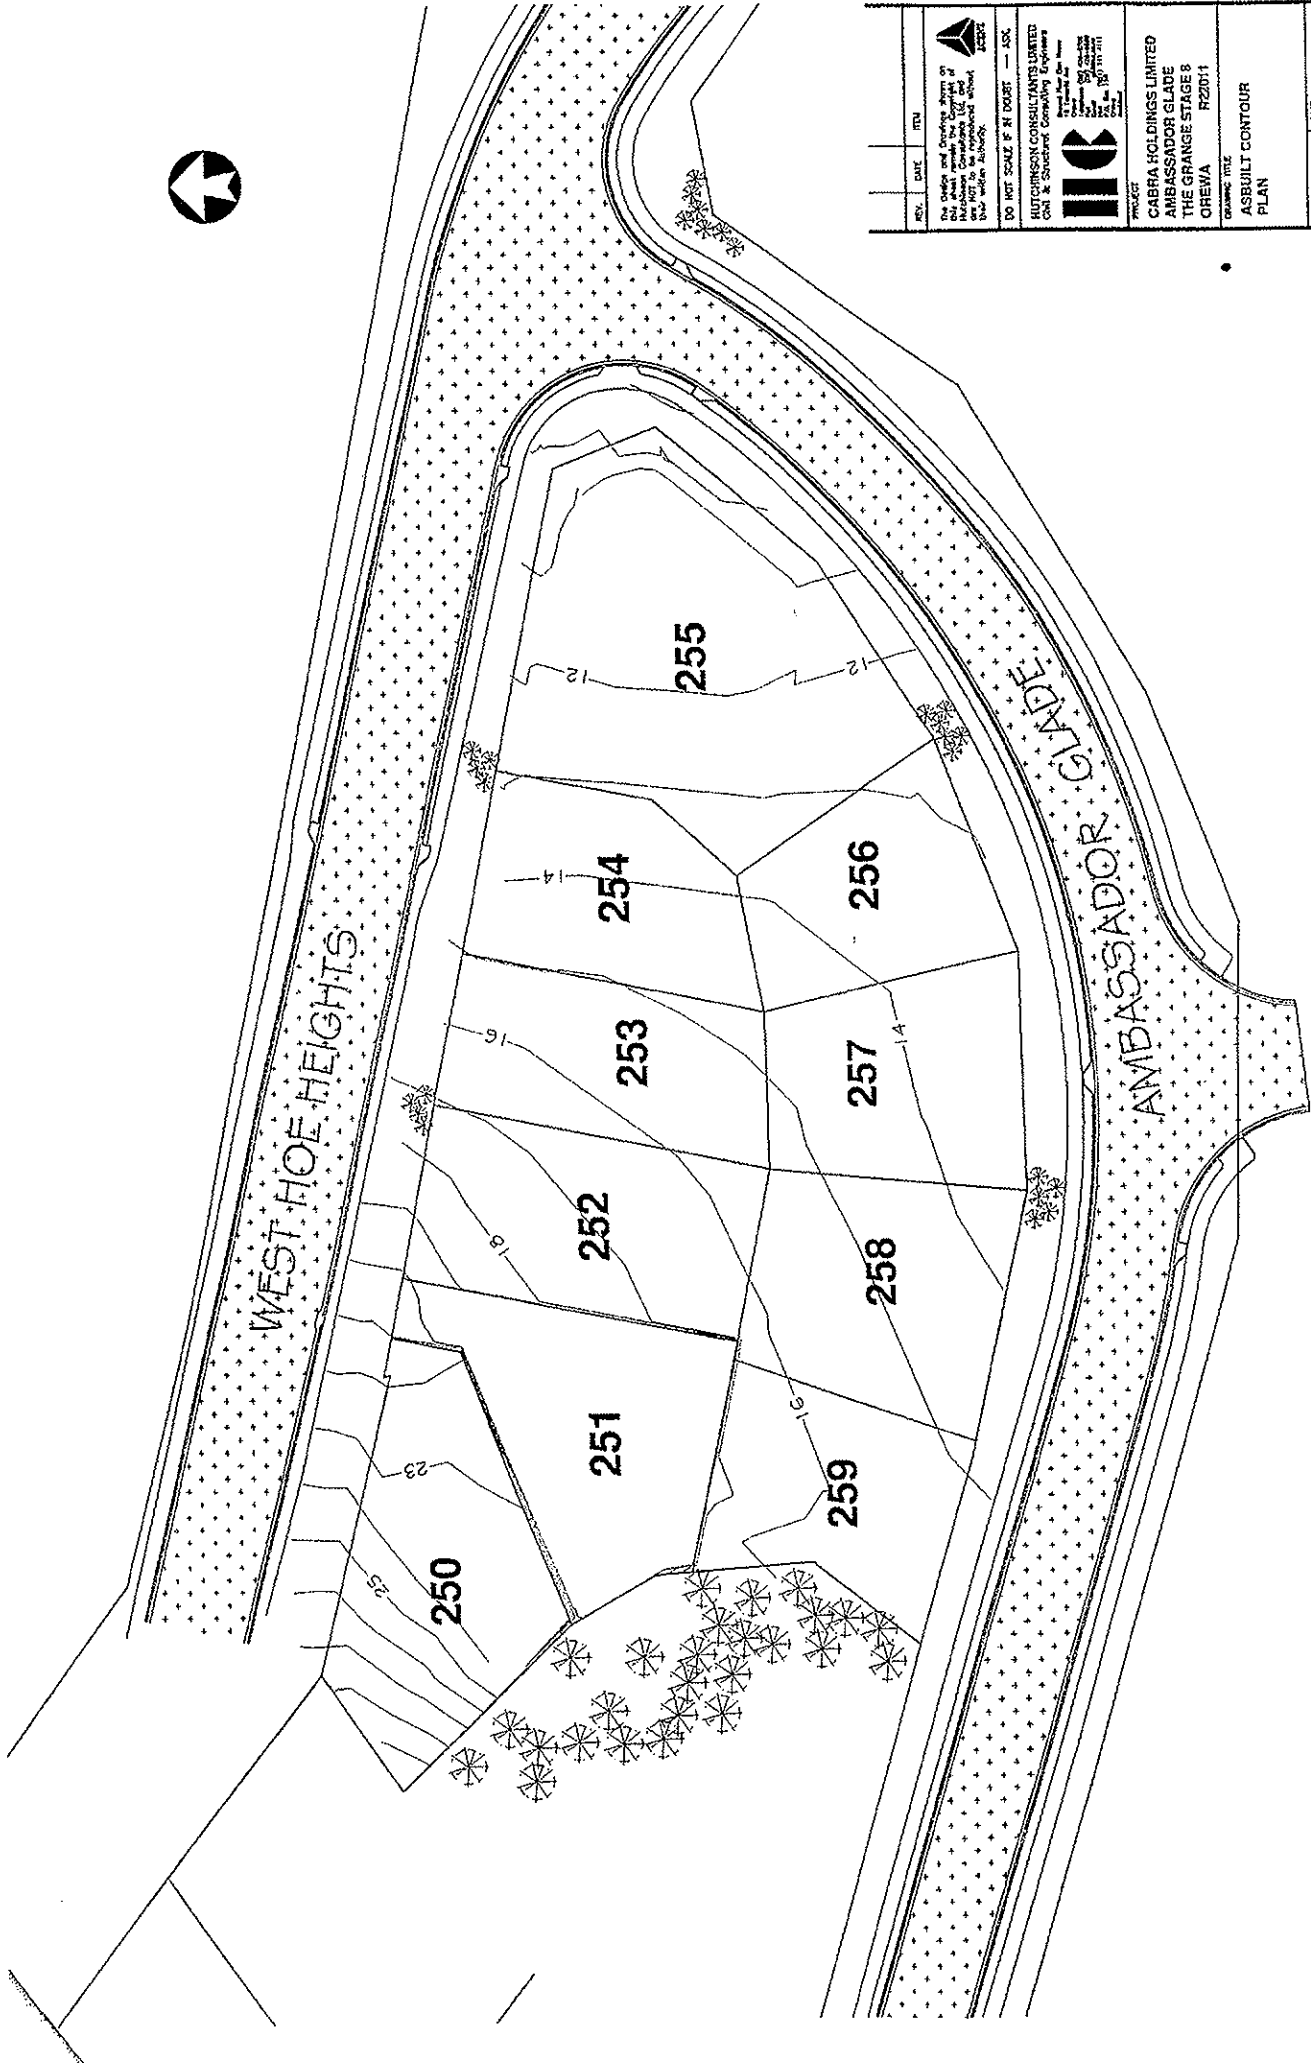

REV.	DATE	ITEM
The Design and Drawing shall be the responsibility of the Engineer and shall not be used for any other purpose without the written authority of the Engineer.		
DO NOT SCALE IF IN DOUBT — SSC		
HIC HUTCHINSON CONSULTANTS (PVT) LIMITED Civil & Structural Consulting Engineers Level 10, 100 Market Street Sydney NSW 2000 Phone: (61) 2 9250 6000 Fax: (61) 2 9250 6001 Email: info@hich.com.au		
PROJECT CABRA HOLDINGS LIMITED AMBASSADOR GLADE THE GRANGE STAGE 8 CREWA R22011		
DRAWING TITLE ASBUILT CONTOUR PLAN		
DRAWN BY	CHKD BY	DATE
PKF	JLS	JUL 2022
SCALE	DWG No.	
1:500 (A3)		
REF.	A3 - 6493 (A) B3	

NOTE:
ALL LEVELS RELATE TO L & S DATUM.
ALL AREAS SUBJECT TO FINAL SURVEY

