

LEGEND:

AS-BUILT WASTEWATER PIPE PE100 PN16 SDR11		63mmØ
AS-BUILT ISOLATION VALVE		
AS-BUILT REDUCER		
AS-BUILT BOUNDARY KIT (SINGLE)		
AS-BUILT BOUNDARY KIT (DOUBLE)		
AS-BUILT FLUSHING PIT		

I certify that these As-built Plans are an accurate record of the works undertaken and that:

- The **Coordinates** (X, Y) are in terms of NZTM on NZGD (2000).
- The **Levels** (Z) are in terms of the Auckland 1946 (MSL) LINZ datum (DOSLI datum).

Signed:


Chartered Professional Engineer
 Date: 16 September 2016
 Name: Evan Alexander Peters
 Contact Phone: (09) 426 6552
 Email: evan@aspeng.co.nz

REV.	DESCRIPTION	CHECK	APP'D	DATE	SCALE 1:1000 AT A3	NAME	DATE	CLIENT	SITE ADDRESS	DRAWING NUMBER	DATE	REVISION	ASPIRE CONSULTING ENGINEERS	
														ASPIRE CONSULTING ENGINEERS
								CABRA DEVELOPMENTS LIMITED	56 LOT RESIDENTIAL SUBDIVISION (STAGES 1 TO 3) 202 & 218 MATUA ROAD, HUAPAI R65429 RDC21584 #44397	1138 - AB - WW501	SEPT 2016	-	Ph: 09 426 6552 Web: www.aspeng.co.nz	
								Conditions of Use: These drawings shall only be used for the purpose for which they were supplied. Do not measure off this drawing. If doubt please contact Engineer.	DRAWING TITLE					
									ASBUILT WASTEWATER PLAN 1					



LEGEND:

AS-BUILT WASTEWATER PIPE PE100 PN16 SDR11		63mmØ
AS-BUILT ISOLATION VALVE		
AS-BUILT REDUCER		
AS-BUILT BOUNDARY KIT (SINGLE)		
AS-BUILT BOUNDARY KIT (DOUBLE)		
AS-BUILT FLUSHING PIT		

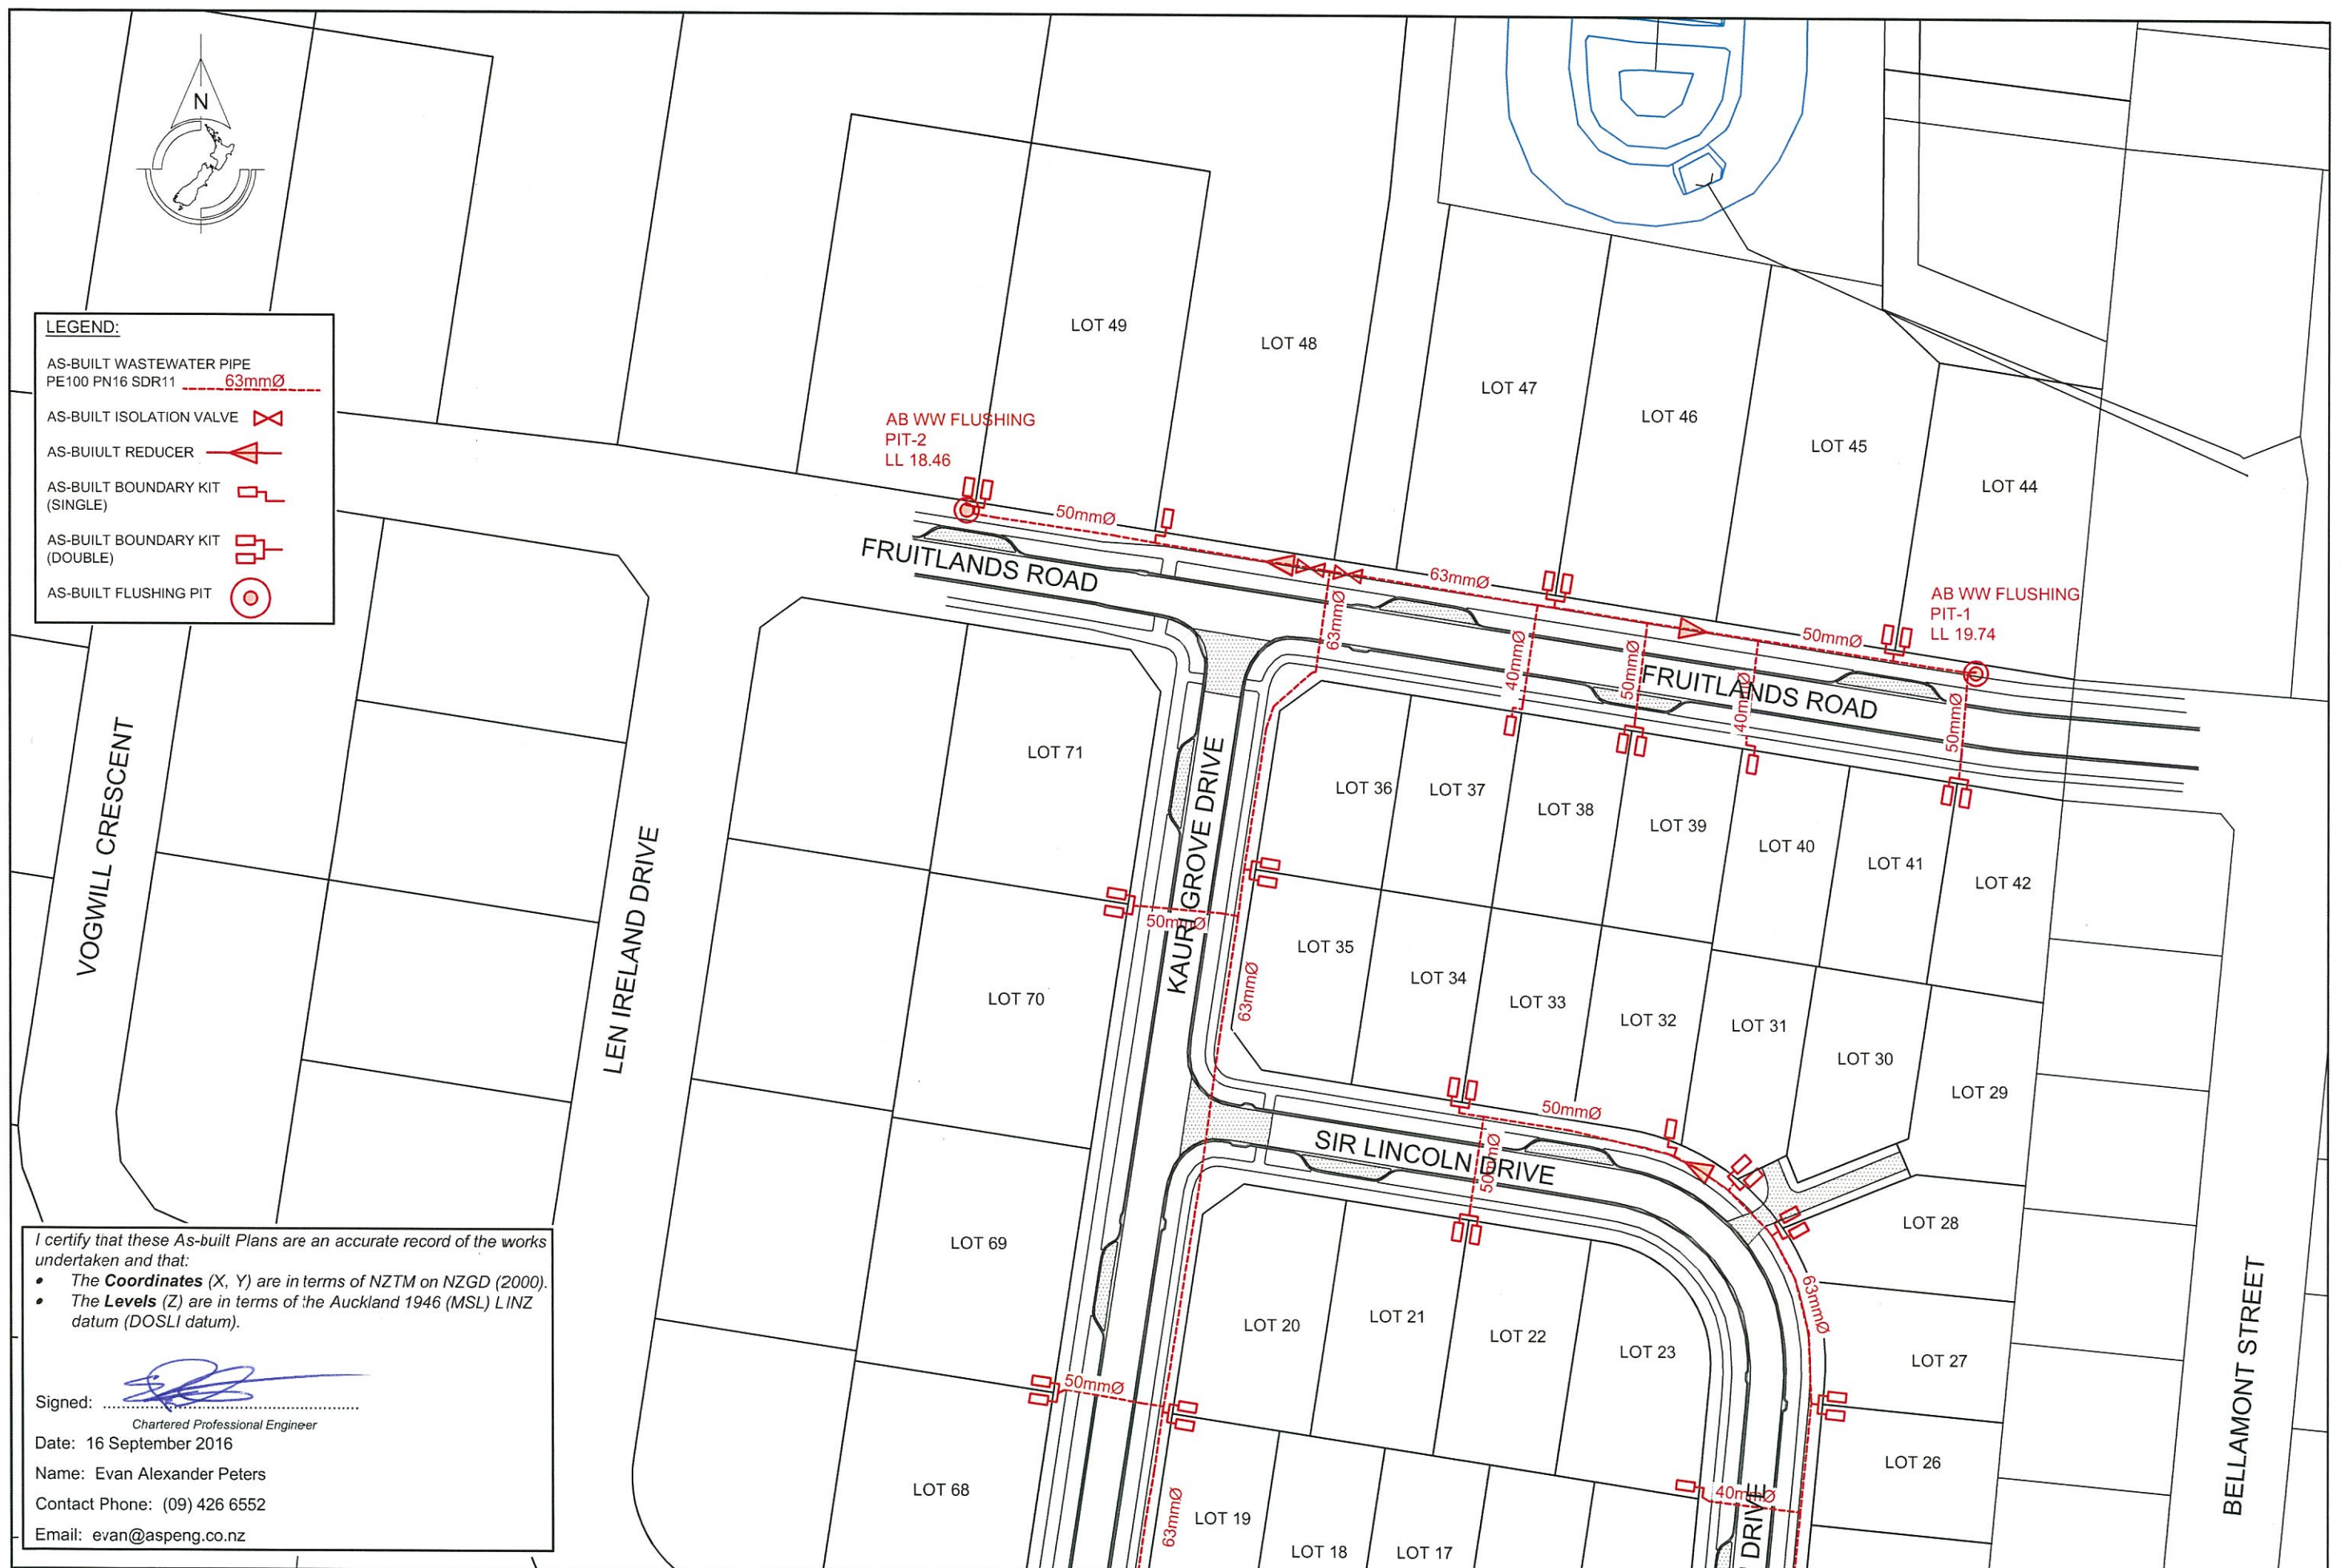

I certify that these As-built Plans are an accurate record of the works undertaken and that:

- The **Coordinates** (X, Y) are in terms of NZTM on NZGD (2000).
- The **Levels** (Z) are in terms of the Auckland 1946 (MSL) LINZ datum (DOSLI datum).

Signed:

Chartered Professional Engineer

Date: 16 September 2016

Name: Evan Alexander Peters

Contact Phone: (09) 426 6552

Email: evan@aspeng.co.nz

REV.	DESCRIPTION	CHECK	APP'D	DATE	SCALE 1:1000 AT A3	CLIENT		SITE ADDRESS	DRAWING NUMBER	
						CABRA DEVELOPMENTS LIMITED				56 LOT RESIDENTIAL SUBDIVISION (STAGES 1 TO 3) 202 & 218 MATUA ROAD, HUAPAI R65429 RDC21584 #44397
						NAME	DATE	DRAWING TITLE	DATE	
						MJ	09.16			ASBUILT WASTEWATER PLAN 2
						MJ	09.16			
						PF	09.16			
						PF	09.16			
						EP	09.16			
<p>Conditions of Use: These drawings shall only be used for the purpose for which they were supplied. Do not measure off this drawing. If doubt please contact Engineer.</p>										Ph: 09 426 6552 Web: www.aspeng.co.nz